

Surveyors Package

DHEC-OCRM

Dewees Island

March 29, 1999

Introduction

The 1990 Beachfront Management Act defines the method by which beachfront jurisdiction is established by the South Carolina Department of Health and Environmental Control, Office of Ocean and Coastal Resource Management (OCRM). The Beachfront Management Act requires that all shorelines be classified as inlet zones or standard zones. Inlet zones are further subdivided into stabilized inlet zones or unstabilized inlet zones.

In unstabilized inlet zones, the baseline is located at the most landward position of the shoreline in the past 40 years, unless the best available scientific and historical data of the inlet and adjacent beaches indicate that the shoreline is unlikely to return to its former position. In standard zones and stabilized inlet zones, the baseline is located at the crest of the primary oceanfront sand dune. If there is no primary dune, the baseline is established based on the volume of sand on the active beach profile at each survey monument.

The position of the setback line is determined by the local long-term erosion rate. In erosional areas, the setback line is located landward of the baseline a distance equal to 40 times the annual erosion rate. In stable or accretional areas, the setback line is located 20 feet landward of the baseline.

All original baselines and setback lines became final on July 3rd, 1991. The Beachfront Management Act calls for all lines to be revised between July 1998 and July 2000, and then once every eight to 10 years after each preceding revision. Once a line is adopted as final, it will not change unless OCRM moves it as the result of a successful legal appeal of the line position or following a successful beach renourishment project. The date on which the new lines for this particular area were adopted as final is listed on the front cover.

Section 48-39-330 of the Beachfront Management Act reads as follows:

Thirty days after the initial adoption by the Department of setback lines, a contract of sale or transfer of real property located in whole or in part seaward of the setback line or the jurisdictional line must contain a disclosure statement that the property is or may be affected by the setback line, baseline, and the seaward corners of all habitable structures referenced to the South Carolina State Plane Coordinate System (N.A.D.-1983) and include the local erosion rate most recently made available by the Department for that particular standard zone or inlet zone as applicable. Language reasonably calculated to call attention to the existence of baselines, setback lines, jurisdictional lines, and the seaward corners of all habitable structures and the erosion rate complies with this section. The provisions of this section are regulatory in nature and do not affect the legality of an instrument violating the provisions.

As a result, surveyors have been called upon to transfer the OCRM baseline and setback lines to individual plats and to locate these lines in the field. OCRM has undertaken several steps to facilitate this task, as described below.

Orthophotographs

Orthophotographs, which are aerial photographs with the distortion removed at ground level, have been produced for all developed beaches in the state. These maps are to national map accuracy standards, and are depicted in the South Carolina State Plane Coordinate System (NAD 83). The maps are based on July 1993 photography, are at a scale of 1"=100', and have the beach lines drawn on them. Copies of these maps are available for review in the appropriate OCRM office and municipal or county office. Copies are available for sale at Duncan-Parnell, Inc., 3150 W. Montague Ave., North Charleston, SC, 29419, phone 843-747-6033.

Digitized Lines

OCRM has digitized the location of the baseline and setback line for all islands where such lines have been established. These digital line coordinates are listed as northings and eastings in the South Carolina State Plane Coordinate System (NAD 83), in units of international feet. They are provided in order to avoid having different surveyors obtain slightly different results when digitizing or scaling off the orthophotographs. Appendix 1 gives the line coordinates for this area.

Beach Survey Monuments

In 1987, OCRM installed a network of beach survey monuments along most of South Carolina's shoreline. Over time, additional monuments have been added to the network to replace ones that have been destroyed. In general, the replacement monument is along the same shore-perpendicular line as the original monument but farther landward. Replacement monuments are stamped with the letter "B" (or the letter "C" for a third-generation monument). For example, monument 4220 was replaced with 4220B. These monuments are located horizontally in the South Carolina State Plane Coordinate System (NAD 83), and are vertically referenced to 1929 NGVD. Description sheets for all monuments in this are given in Appendix 2. In some cases, the monument's coordinates are given in meters. To convert to international feet, divide by 0.3048.

Local Erosion Rate

OCRM has conducted studies of the long-term erosion rates at all survey monument locations. These rates were used to establish the location of the setback line, and must also be given on individual plats. In erosional areas the exact rate was determined. In stable or accretional areas no specific number was determined, and the shoreline is officially classified as "stable to accretional" or S/A. Local erosion rates for the area covered by this report are given in Appendix 3.

Plat Review Requirements

In order to receive a permit from OCRM for many activities seaward of the setback line, the applicant must submit a plat in state plane coordinates with specific information shown on it. The following is a list of the required information:

1. Monuments used to reference the survey
2. Line coordinates used to establish the baseline and setback line
3. Coordinates of the property corners
4. Coordinates of the corners of any habitable structures on the property
5. Distance between the seaward structure corners and the baseline and setback line
6. Footprint of all structures on the property
7. Location of the crest and trough of the primary oceanfront sand dune
8. Local erosion rate

Appendix 1

This appendix contains a listing of OCRM baseline and setback line coordinates, given as northings and eastings in international feet referenced to the South Carolina State Plane Coordinate System (NAD 83). Coordinates are listed as one continuous line that begins at one end of the island or beach and extends to the other. There are separate listings for the baseline and the setback line.

DHEC-OCRM BASELINE COORDINATES
DEWEES ISLAND
VALID AS OF 3/29/99
STATE-PLANE COORDINATE SYSTEM, NAD 1983
INTERNATIONAL FEET

NORTHING	EASTING
364203.09	2392216.12
364148.76	2392258.68
364117.97	2392282.21
364103.09	2392302.28
364110.36	2392329.96
364115.55	2392350.36
364127.31	2392391.20
364138.04	2392429.95
364142.19	2392446.56
364132.15	2392480.13
364119.35	2392493.62
364106.20	2392499.16
364091.33	2392505.73
364087.52	2392513.00
364082.68	2392522.34
364080.95	2392526.49
364078.87	2392536.87
364076.10	2392554.86
364083.37	2392594.31
364091.85	2392640.69
364109.66	2392698.81
364123.85	2392743.44
364126.96	2392752.78
364142.54	2392780.81
364162.95	2392817.14
364192.36	2392871.81
364225.23	2392932.71
364238.59	2392958.65
364261.56	2393000.18
364280.59	2393035.13
364295.82	2393063.50
364306.89	2393082.53
364330.07	2393117.48
364345.99	2393142.39
364351.48	2393152.97
364390.97	2393219.55
364416.58	2393262.80
364438.72	2393293.25
364460.17	2393324.74
364468.31	2393336.00
364492.70	2393371.45
364506.19	2393390.13
364519.69	2393415.39
364536.30	2393446.19
364552.56	2393478.02
364559.82	2393494.63
364570.90	2393519.89
364583.35	2393548.95
364586.12	2393555.53
364602.04	2393571.10
364627.64	2393594.28
364648.40	2393614.00
364652.55	2393617.81

364666.40	2393645.14
364688.50	2393689.99
364707.22	2393728.88
364713.45	2393739.95
364752.90	2393782.86
364788.54	2393820.23
364813.80	2393848.25
364829.37	2393876.62
364842.17	2393901.19
364848.40	2393912.96
364877.81	2393955.86
364900.30	2393989.42
364926.25	2394019.18
364949.43	2394055.86
364961.00	2394076.28
364976.77	2394102.92
365000.99	2394142.71
365024.17	2394179.04
365050.12	2394216.06
365073.30	2394249.28
365095.79	2394281.46
365120.36	2394317.79
365157.73	2394372.11
365180.22	2394409.48
365202.37	2394446.50
365213.44	2394470.72
365219.67	2394486.64
365233.85	2394521.24
365245.96	2394552.73
365259.11	2394589.06
365272.61	2394624.70
365283.68	2394654.80
365293.37	2394676.60
365304.44	2394702.90
365317.59	2394732.65
365328.31	2394758.26
365332.12	2394766.22
365347.34	2394786.98
365373.29	2394820.20
365394.75	2394847.88
365409.28	2394866.56
365435.92	2394900.47
365455.64	2394926.07
365488.52	2394967.94
365515.50	2395003.23
365534.54	2395026.76
365549.56	2395045.75
365571.56	2395070.36
365596.82	2395101.50
365622.08	2395130.91
365641.45	2395158.25
365665.67	2395191.46
365689.47	2395224.60
365699.93	2395239.21
365718.61	2395264.47
365733.49	2395284.54
365743.18	2395305.30
365755.64	2395330.56
365765.67	2395350.98
365777.78	2395376.23

365791.62	2395404.95
365800.62	2395423.64
365812.73	2395439.90
365831.07	2395460.31
365857.71	2395491.11
365886.08	2395523.29
365912.72	2395554.43
365935.22	2395579.00
365943.45	2395589.41
365969.82	2395619.13
365991.62	2395650.27
366014.45	2395681.42
366038.33	2395717.05
366057.36	2395741.28
366065.66	2395750.62
366082.96	2395771.72
366097.15	2395789.02
366137.29	2395796.64
366166.35	2395801.48
366187.80	2395825.70
366225.17	2395866.53
366260.12	2395906.32
366267.73	2395914.63
366308.56	2395942.31
366320.67	2395950.61
366372.23	2395985.56
366384.34	2395993.52
366400.60	2395996.28
366431.39	2396000.44
366453.19	2396011.16
366468.40	2396018.88
366492.98	2396031.23
366522.05	2396046.11
366540.73	2396060.99
366573.26	2396088.32
366596.10	2396107.35
366610.79	2396115.16
366630.70	2396125.35
366638.65	2396129.15
366665.30	2396130.88
366703.36	2396132.96
366725.16	2396134.00
366742.80	2396155.45
366758.80	2396173.94
366776.02	2396195.24
366799.55	2396212.54
366841.07	2396242.30
366871.52	2396264.10
366892.63	2396280.36
366897.00	2396284.60
366912.35	2396298.70
366934.15	2396319.11
366954.91	2396338.49
366963.56	2396346.45
366977.05	2396366.52
366992.62	2396391.08
367010.27	2396418.42
367025.84	2396441.60
367041.41	2396464.09
367058.71	2396479.66

367092.97	2396505.96
367119.61	2396527.07
367146.60	2396547.83
367169.78	2396560.28
367189.16	2396571.01
367222.03	2396589.35
367243.48	2396596.96
367290.54	2396615.64
367311.61	2396623.37
367352.47	2396639.17
367377.39	2396649.90
367383.96	2396652.67
367399.19	2396653.70
367426.17	2396656.13
367440.92	2396658.69
367492.26	2396669.97
367540.01	2396680.69
367556.62	2396686.23
367575.65	2396693.02
367604.02	2396703.53
367638.63	2396716.33
367654.89	2396722.21
367673.76	2396725.50
367718.21	2396732.94
367745.20	2396738.13
367786.37	2396751.28
367812.55	2396759.26
367824.09	2396763.04
367847.62	2396765.81
367881.52	2396768.93
367902.29	2396770.31
367927.54	2396769.27
367950.38	2396768.23
367955.92	2396767.89
367975.64	2396767.20

END

DHEC-OCRM SETBACK LINE COORDINATES
DEWEES ISLAND
VALID AS OF 3/29/99
STATE-PLANE COORDINATE SYSTEM, NAD 1983
INTERNATIONAL FEET

NORTHING	EASTING
364333.90	2392261.61
364341.28	2392305.68
364349.93	2392356.37
364363.10	2392433.49
364372.72	2392489.87
364382.37	2392542.46
364406.07	2392576.37
364433.14	2392615.10
364483.48	2392687.12
364529.62	2392753.14
364563.05	2392800.96
364591.88	2392843.21
364605.92	2392884.12
364627.20	2392954.00
364648.97	2393025.48
364672.38	2393102.36
364689.58	2393158.82
364716.94	2393195.81
364761.33	2393255.82
364795.36	2393301.82
364819.79	2393334.85
364845.29	2393369.32
364877.26	2393391.15
364923.99	2393423.04
364969.21	2393453.92
365015.98	2393485.84
365057.51	2393514.19
365086.07	2393533.69
365121.28	2393568.90
365163.58	2393611.19
365213.26	2393660.87
365262.26	2393709.88
365296.50	2393744.12
365325.41	2393773.02
365363.07	2393830.66
365398.51	2393884.90
365430.50	2393933.86
365467.35	2393990.26
365491.21	2394025.34
365510.68	2394082.28
365536.78	2394158.61
365571.39	2394259.87
365601.89	2394350.64
365605.19	2394360.88
365618.12	2394410.05
365639.54	2394490.36
365663.69	2394580.95
365685.85	2394664.05
365712.18	2394698.29
365764.07	2394765.79
365805.82	2394820.12
365848.78	2394875.99
365876.88	2394930.58

365928.01	2395029.88
365960.14	2395092.30
365997.27	2395167.25
366033.81	2395230.06
366070.48	2395293.14
366119.45	2395377.36
366141.46	2395415.22
366197.09	2395478.16
366255.42	2395544.15
366300.24	2395594.87
366338.98	2395638.70
366392.49	2395680.87
366450.95	2395726.95
366515.85	2395778.11
366584.09	2395831.90
366623.16	2395864.41
366718.29	2395943.59
366764.40	2395981.97
366816.22	2396025.10
366850.55	2396066.08
366926.40	2396156.61
366974.97	2396214.58
366995.00	2396238.48
367016.60	2396282.67
367054.32	2396359.83
367084.65	2396421.86
367121.88	2396498.00
367155.18	2396527.22
367203.97	2396557.72
367264.96	2396583.86
367329.44	2396608.26
367363.62	2396621.73
367391.49	2396633.53
367422.67	2396635.27
367456.65	2396640.49
367516.77	2396654.44
367567.39	2396666.69
367620.46	2396686.67
367653.57	2396697.13
367687.55	2396705.84
367765.10	2396720.66
367799.95	2396732.85
367843.52	2396740.70
367906.25	2396748.54
367969.86	2396748.54

END


Appendix 2

This appendix contains descriptions of all OCRM beach survey monuments in the area.

**SOUTH CAROLINA COASTAL COUNCIL
CONTROL SURVEYS
ADDITIONAL MONUMENTS SET ON DEWEES ISLAND**

PROJECT : SCCC BEACH MONITORING BASELINE STATION NO. : 3210
 STATE : SOUTH CAROLINA COUNTY : Charleston EST. BY : G. Robert George & As
 NAD 83 - SINGLE ZONE SPC - MAPPING ANGLE : 0° 42' 27.18 SCALE FACTOR : 0.9999005
 HORIZONTAL ORIGIN : Kuyler VERTICAL ORIGIN : DeWees Is. Tide Station(86651
 NORTHING : (M) 111,096.908 364491.4 EASTING : (M) 729,084.576 2,392,009.7
 LATITUDE : 32° 49' 42.40798 LONGITUDE : 79° 43' 25.51708
 ELEVATION ~~FEET~~ ^{N.T.L.} 16.38 DATE : June 1990
 (Local Mean Tide Level)


OBJECT	GEODETIC AZIMUTH	GRID BEARING	HORIZONTAL DISTANCE
3220	124° 18' 05.8720	SE 56° 24' 21.686	202.0659 (M) (Grid)
	• • •	• • •	202.0859 (M) (Geodetic)

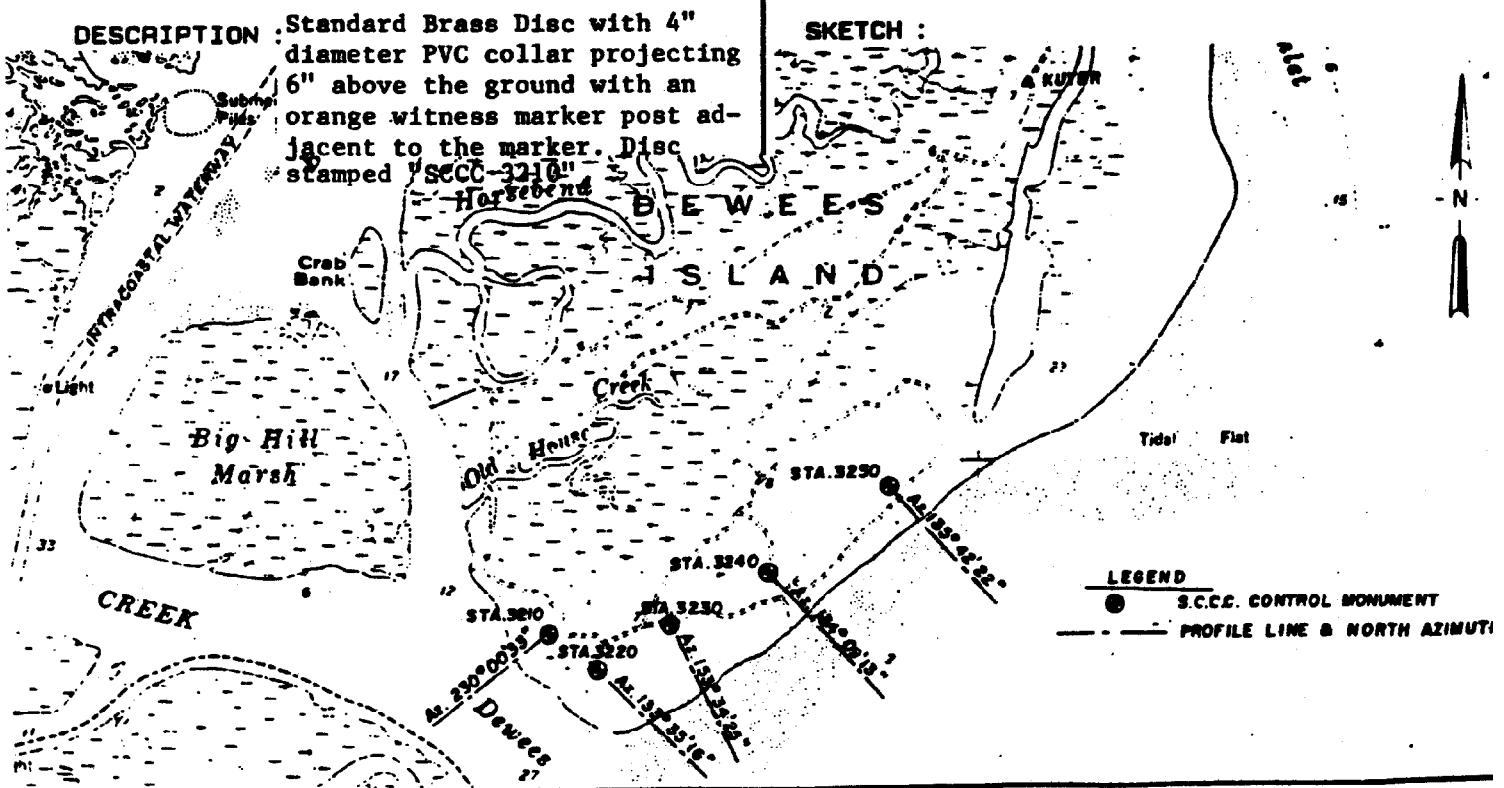

**SOUTH CAROLINA COASTAL COUNCIL
CONTROL SURVEYS
ADDITIONAL MONUMENTS SET ON DEWEES ISLAND**

PROJECT : SCCC BEACH MONITORING BASELINE STATION NO. : 3220
 STATE : SOUTH CAROLINA COUNTY : Charleston EST. BY : G. Robert George & Ass
 NAD 83 - SINGLE ZONE SPC - MAPPING ANGLE : 00° 42' 30.74" SCALE FACTOR : 0.9999008
 HORIZONTAL ORIGIN : Kuyler VERTICAL ORIGIN : DeWees Is. Tide Station(86651
 NORTHING : (M) 110,985.1040 2⁹12A.3A EASTING : (M) 729252.8921 2³⁹2561.90
 LATITUDE : 32° 49' 38.71107 LONGITUDE : 79° 43' 19.09871
 ELEVATION ~~16.23~~ FEET M.T.L. DATE : June 1990
 (Local Mean Tide Level)


OBJECT	GEODETIC AZIMUTH	GRID BEARING	HORIZONTAL DISTANCE
3210	304° 18' 09.3515	NW 56° 24' 21.686	202.0659 (M) (Grid)
3230	58° 00' 36.452	NW 57° 26' 05.703	202.0859 (M) (Geodetic)
			285.9180 (M) (Grid)
			285.9467 (M) (Geodetic)

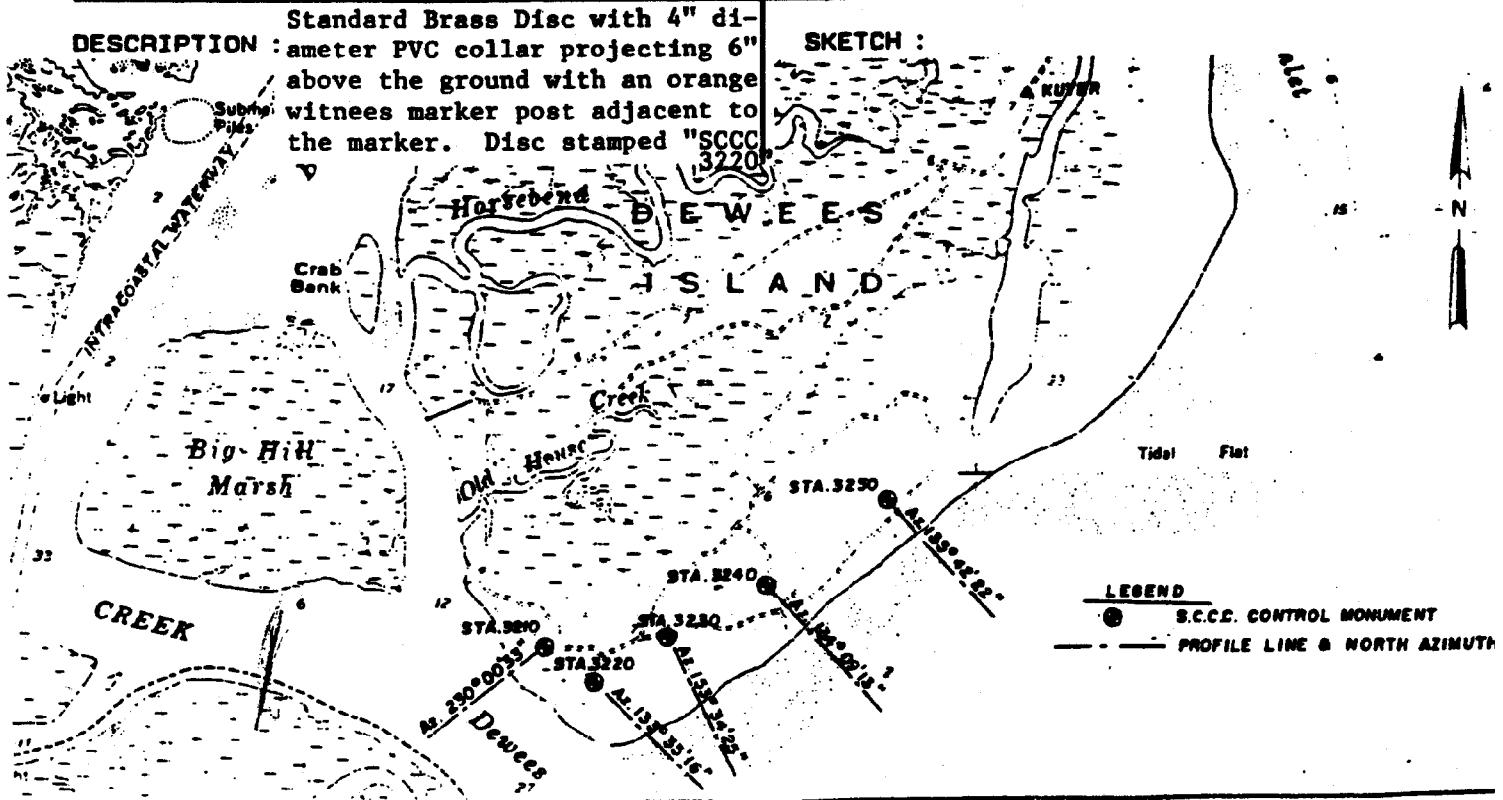

SOUTH CAROLINA COASTAL COUNCIL
CONTROL SURVEYS
ADDITIONAL MONUMENTS SET ON DEWEES ISLAND

PROJECT : SCCC BEACH MONITORING BASELINE STATION NO. : 3230
 STATE : SOUTH CAROLINA COUNTY : Charleston EST. BY : G. Robert George & A.
 NAD 83 - SINGLE ZONE SPC - MAPPING ANGLE : 00° 42' 35.91" SCALE FACTOR : 0.9999004
 HORIZONTAL ORIGIN : Kuyler VERTICAL ORIGIN : DeWees Is. Tide Station(86651)
 NORTHING : (M) 111,139.0015 36A, 631, 26 EASTING : (M) 729,493.8582 2,393, 252.5
 LATITUDE : 32° 49' 43.61006 LONGITUDE : 79° 43' 09.76068
 ELEVATION ~~FEET MSL~~ ^{M.T.L.} 9.00 DATE : June 1990
 (Local Mean Tide Level)


OBJECT	GEODETIC AZIMUTH	GRID BEARING	HORIZONTAL DISTANCE
3220	238° 08' 41.5143	SW 57° 26' 05.703	285.9180 (M) (Grid)
3240	61° 57' 55.7126	NE 61° 15' 19.654	285.9467 (M) (Geodetic)
			367.074 (M) (Grid)
			367.1106 (M) (Geodetic)

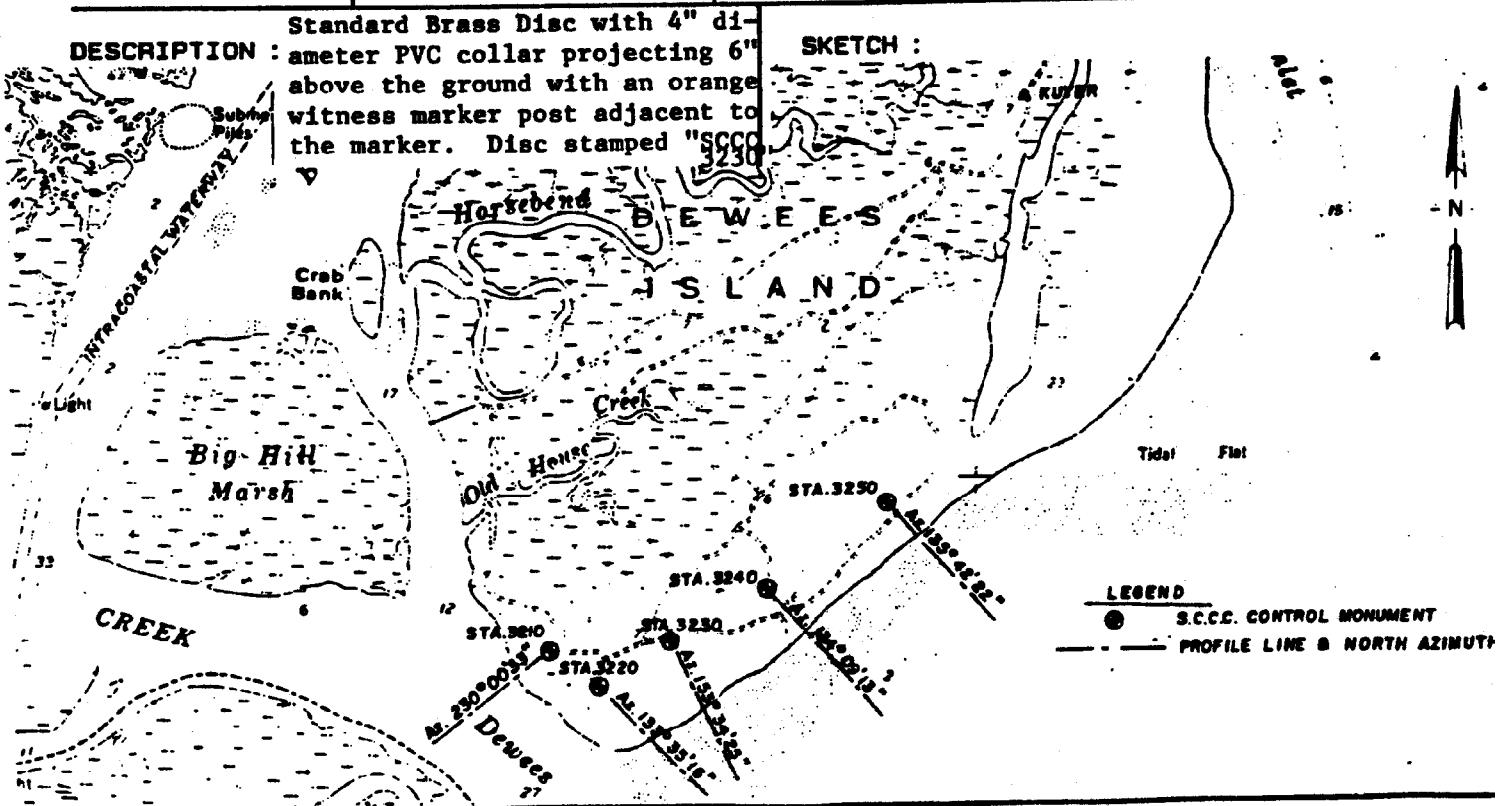

**SOUTH CAROLINA COASTAL COUNCIL
CONTROL SURVEYS
ADDITIONAL MONUMENTS SET ON DEWEES ISLAND**

PROJECT : SCCC BEACH MONITORING BASELINE STATION NO. : 3240
 STATE : SOUTH CAROLINA COUNTY : Charleston EST. BY : G. Robert George & As:
 NAD 83 - SINGLE ZONE SPC - MAPPING ANGLE : 00° 42' 42.82" SCALE FACTOR : 0.9999000
 HORIZONTAL ORIGIN : Kuyler VERTICAL ORIGIN : DeWees Is. Tide Station (866511)
 NORTHING : (M) 111,315.5294 36-5,208.39 EASTING : (M) 729,815.6989
 LATITUDE : 32° 49' 49.21086 LONGITUDE : 79° 42' 57.30199 2,399,403.10
 ELEVATION ~~FEET ASL~~ ^{M.T.L.} : 7.65 DATE : June 1990
 (Local Mean Tide Level)

OBJECT	GEODETIC AZIMUTH	GRID BEARING	HORIZONTAL DISTANCE
3230	241° 58' 02.4670	SW 61° 15' 19.654	367.0742 (M) (Grid)
3250	54° 59' 08.0162	NE 54° 16' 25.151	367.1106 (M) (Geodetic)
			496.2099 (M) (Grid)
			496.2598 (Geodetic)

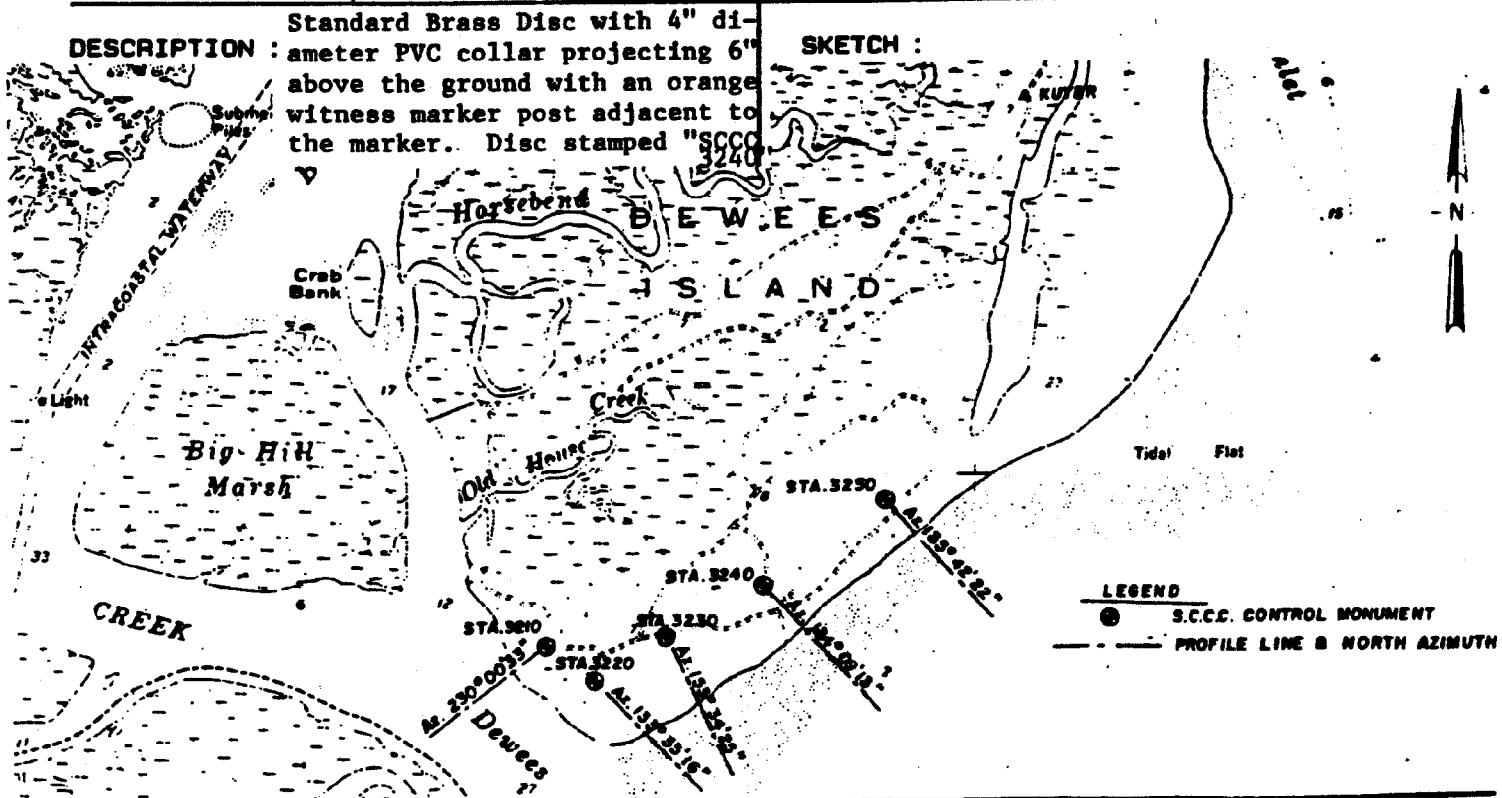


SOUTH CAROLINA COASTAL COUNCIL
CONTROL SURVEYS
ADDITIONAL MONUMENTS SET ON DEWEES ISLAND

PROJECT : SCCC BEACH MONITORING BASELINE STATION NO. : 3250
 STATE : SOUTH CAROLINA COUNTY : Charleston EST. BY : G. Robert George & Ass
 NAD 83 - SINGLE ZONE SPC - MAPPING ANGLE : 00° 42' 51.48" SCALE FACTOR : 0.9998994
 HORIZONTAL ORIGIN : Kuyler VERTICAL ORIGIN : DeWees Is. Tide Station(866511)
 NORTHING : (M) 111,605.2736 366^{159.07} EASTING : (M) 730,218.5296 23^{95.73}
 LATITUDE : 32° 49' 58.45378 LONGITUDE : 79° 42' 41.67450
 ELEVATION ~~6.63~~ FEET M.T.L. DATE : June 1990
 (Local Mean Tide Level)

OBJECT	GEODETIC AZIMUTH	GRID BEARING	HORIZONTAL DISTANCE
3240	234° 59' 16.489	SW 54° 16' 25.151	496.2099 (Grid) (M)
Kuyler	19° 19' 56.1409	NE 18° 37' 04.498	496.2598 (Geodetic) 1431.1577 (Grid) 1431.3041 (Geodetic)

DESCRIPTION : Standard Brass Disc with 4" diameter PVC collar projecting 6" above the ground with an orange witness marker post adjacent to the marker. Disc stamped "SCCC".

SKETCH :

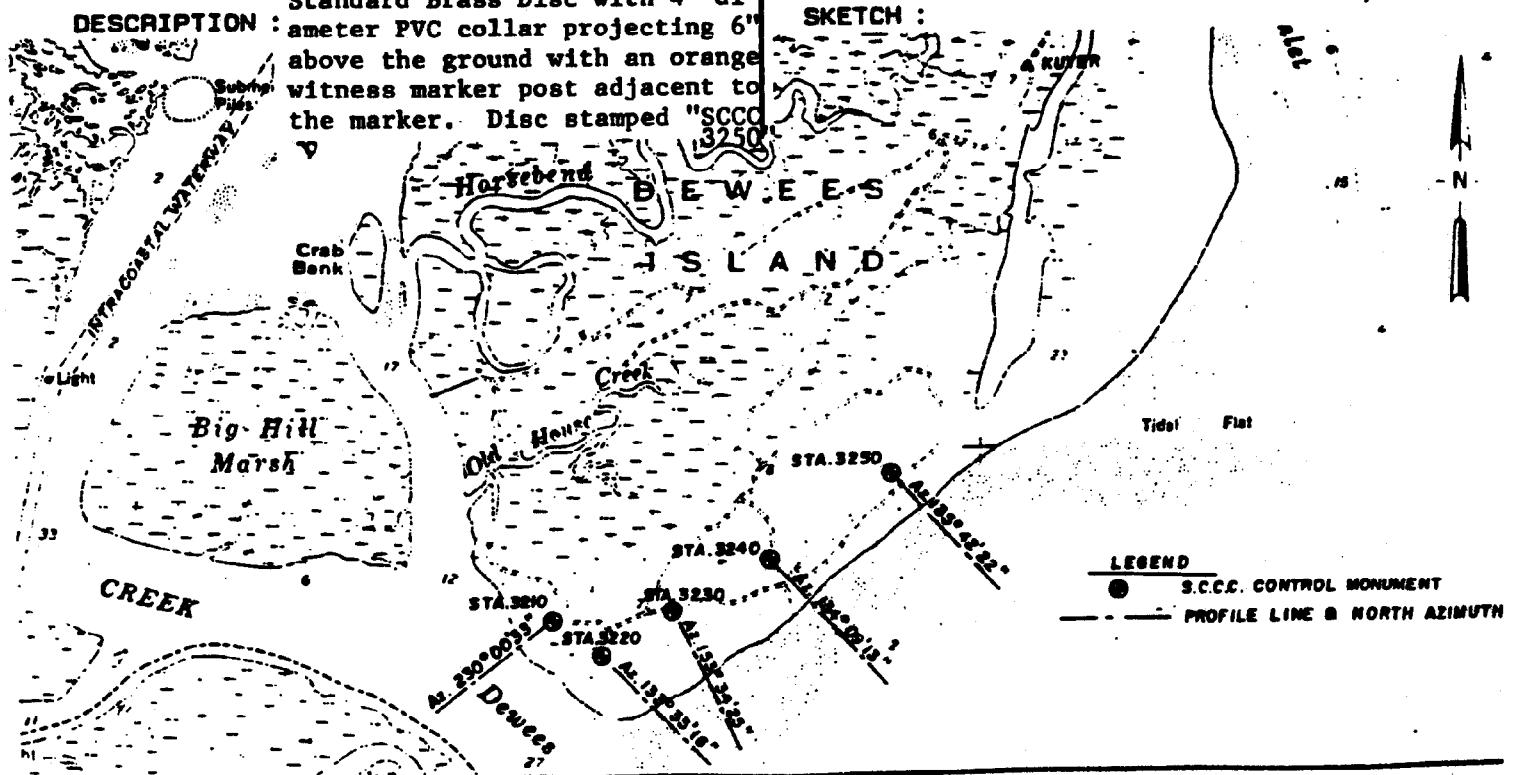

Appendix 3

This appendix contains shoreline change rates for this area, given in feet per year. A negative number indicates erosion. A stable or accretional shoreline is designated S/A.

The erosion rate for Dewees Island varies significantly from place to place. To obtain the local erosion rate for a particular parcel, measure the distance between the baseline and the setback line and divide by 40. This number is the annual erosion rate, in feet per year.